

SOUTHEASTERN DISTRICT HEALTH DEPARTMENT  
INDIVIDUAL SEWAGE DISPOSAL INSTALLATION PERMIT

Permit No. 118073B

Date Dec 13, 1973

Installation for Alma Tolman (Name) at T 73 R 34 E Sec 1 (Legal description of property)

Address of Installation So Main Extension

No. Living Units 1 Bedrooms 3 People Served \_\_\_\_\_ Water Supply--Private \_\_\_\_\_ Public X Applicant is: Contractor X Other \_\_\_\_\_

FHA \_\_\_\_\_ FARM HOME \_\_\_\_\_ VA \_\_\_\_\_ CONV. X EXISTING X NO. \_\_\_\_\_

Septic Tank 1000 gal. here

Effluent Disposal: Effective Area Required 650 sq. ft. Soil System: Perc. Rate \_\_\_\_\_ Min./in. Min. Depth to Ground Water \_\_\_\_\_ ft. Soil Profile \_\_\_\_\_

Field Drain \_\_\_\_\_ Absorption Bed \_\_\_\_\_ Standard X Modified \_\_\_\_\_ Seepage Pit X Dimensions 10X20

Distance from Disposal Area to:

Property Lines: Front 210 ft. Back 210 ft. Side 210 ft. Dwelling Foundation 20 ft. Well \_\_\_\_\_ ft. Surface Water \_\_\_\_\_ ft. Nearest Neighbor's Well \_\_\_\_\_ ft. Plot Plan Submitted and Approved X Septic Tank 10 ft.

Remarks: To repair seepage area only

Applicant Alma Tolman Paid \_\_\_\_\_ Bill \_\_\_\_\_ No Fee X

Address \_\_\_\_\_ Permit Issued by Jaren Tolman

INSPECTION: Septic Tank Size already in Standpipe \_\_\_\_\_ Depth to Manhole \_\_\_\_\_

Distance from Septic Tank to: Dwelling Foundation \_\_\_\_\_ ft. Well \_\_\_\_\_ ft. Nearest Neighbor's Well \_\_\_\_\_ ft.

Effluent Disposal: Effective Area \_\_\_\_\_ sq. ft. Field Drain \_\_\_\_\_ Absorption Bed \_\_\_\_\_ Standard \_\_\_\_\_ Modified \_\_\_\_\_ Seepage Pit \_\_\_\_\_ Dimensions \_\_\_\_\_


Pipe Size \_\_\_\_\_ No. of Lines \_\_\_\_\_ Length \_\_\_\_\_ Depth \_\_\_\_\_

Distance from Disposal Area to: Property Lines: Front \_\_\_\_\_ ft. Back \_\_\_\_\_ ft. Side \_\_\_\_\_ ft. Dwelling Foundation \_\_\_\_\_ ft. Well \_\_\_\_\_ ft. Surface Water \_\_\_\_\_ ft. Water Service Piping \_\_\_\_\_ ft. Depth to Gravel \_\_\_\_\_ ft. Nearest Neighbor's Well \_\_\_\_\_ ft.

Approved ✓ Not Approved \_\_\_\_\_ Inspected 1-31-74 by J. Tolman Installed by R. Browning (Date)

Remarks \_\_\_\_\_

Applicant's sketch of house, proposed sewage layout and all adjacent wells (dimension between all components) --

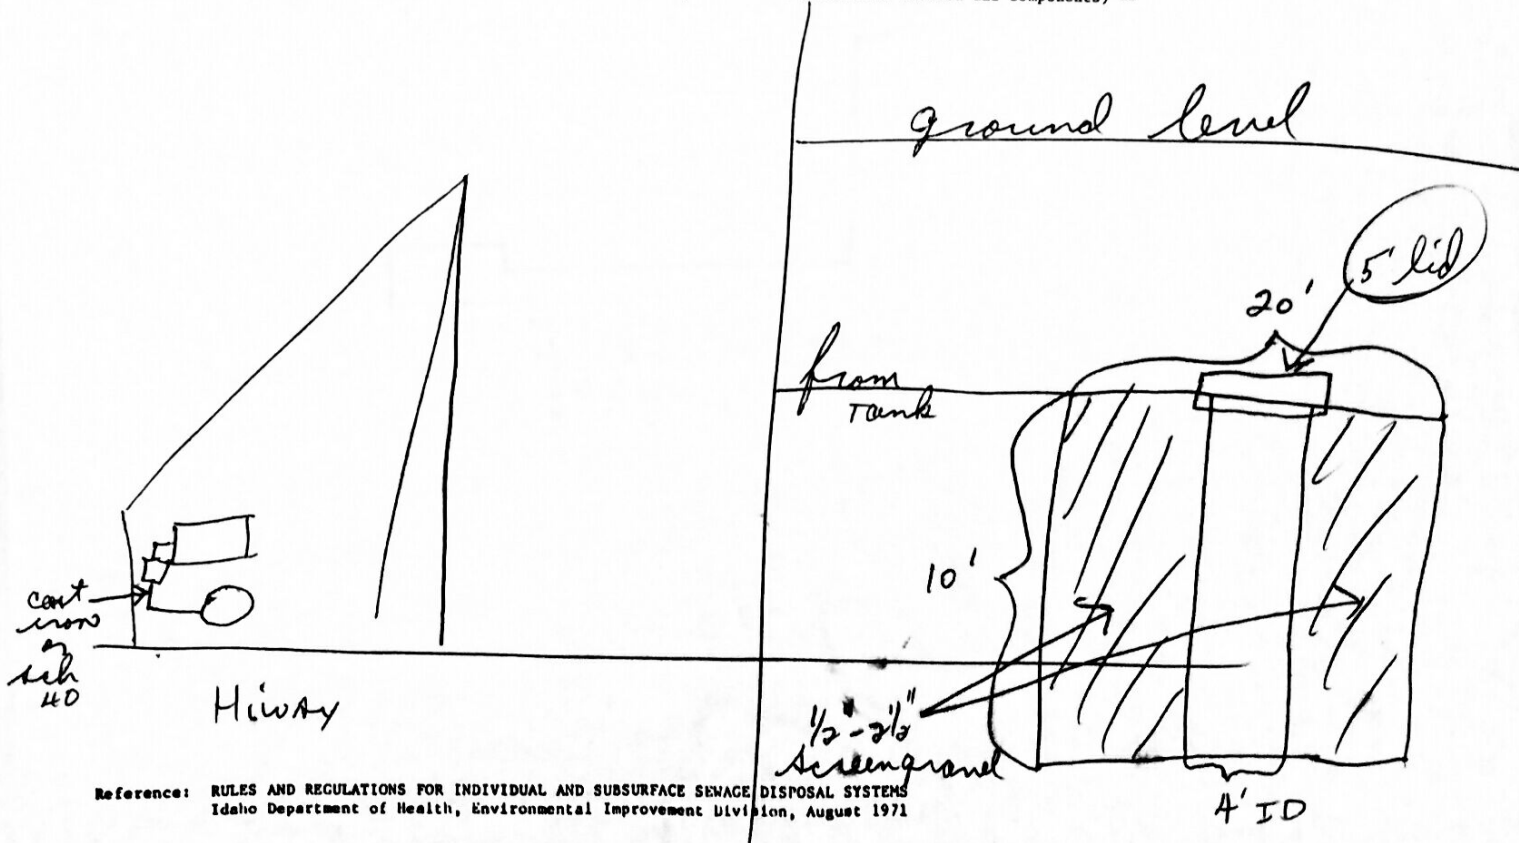

Reference: RULES AND REGULATIONS FOR INDIVIDUAL AND SUBSURFACE SEWAGE DISPOSAL SYSTEMS  
Idaho Department of Health, Environmental Improvement Division, August 1971