

**SOUTHEASTERN DISTRICT HEALTH DEPARTMENT
INDIVIDUAL SEWAGE DISPOSAL INSTALLATION PERMIT**

Permit No. _____ Date 4/10/72
 Installation for KD Mobile Home Court at S/2 S/2 NW/4 SW/4 section 5 (Twp 6S, Range 34 E 6M Idaho)
 (Name) (Legal description of property)

Address of Installation Rio Vista Rd Box 100 Pocatello Idaho 83201
 No. Living Units 3 Bedrooms 6 People Served 7-8 Water Supply--Private Public _____ Applicant is: Owner Contractor _____ Other _____
 FHA _____ FARM HOME _____ VA _____ CONV. _____ EXISTING _____ NO. _____

Septic Tank 2000 gal. Perc. Rate _____ Min./in. Min. Depth to Ground Water _____ ft.
 Effluent Disposal: Effective Area Required 450 sq. ft. Soil System: _____ Soil Profile _____
 Field Drain _____ Absorption Bed _____ Standard _____ Modified _____ Seepage Pit Dimensions 4' con - 15' wide - 10' deep


Distance from Disposal Area to:
 Property Lines: Front 150 ft. Back 1100 ft. Side 120 ft. Dwelling Foundation _____ ft. Well 150 ft.
 Surface Water _____ ft. Nearest Neighbor's Well 300 ft. Plot Plan Submitted and Approved _____ Septic Tank 10 ft.

Remarks: _____
 Applicant Marked David Smith Paid _____ Bill _____ No Fee
 Address _____ Permit Issued by Jaren Salzman

INSPECTION: Septic Tank Size 2000 Standpipe yes Depth to Manhole 8 ft
 Distance from Septic Tank to: Dwelling Foundation OK ft. Well _____ ft. Nearest Neighbor's Well _____ ft.
 Effluent Disposal: Effective Area 450 sq. ft. Field Drain _____ Absorption Bed _____ Standard _____ Modified _____ Seepage Pit _____ Dimensions 11x8x15

Pipe Size _____ No. of Lines _____ Length _____ Depth _____
 Distance from Disposal Area to: NA
 Property Lines: Front _____ ft. Back _____ ft. Side _____ ft. Dwelling Foundation _____ ft. Well _____ ft.
 Surface Water _____ ft. Water Service Piping _____ ft. Depth to Gravel _____ ft. Nearest Neighbor's Well _____ ft.

Approved Not Approved _____ Inspected 5/11/72 by Jaren Salzman Installed by self
 Remarks _____
Resir checked 5/10
checked 5/11

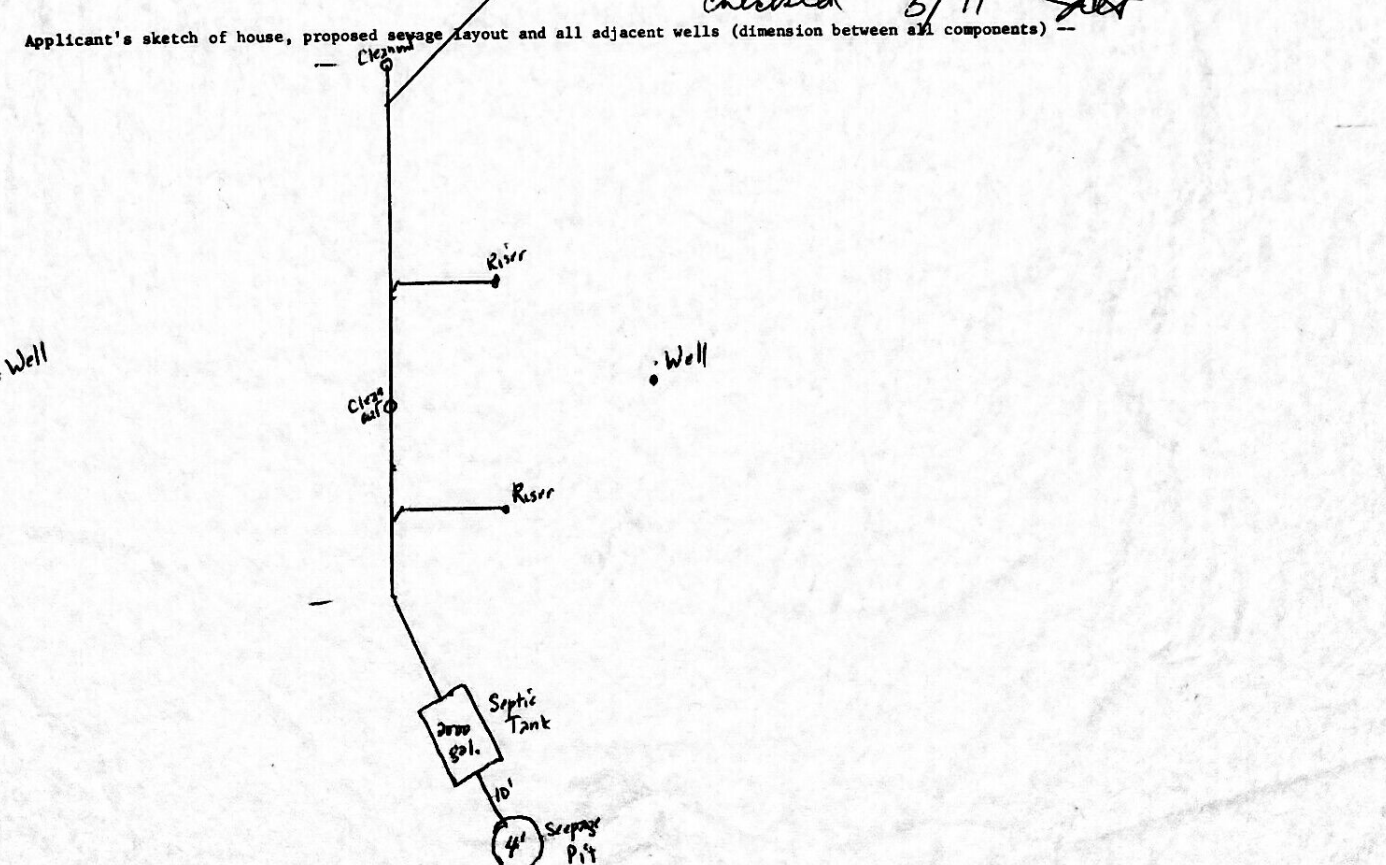

Neighbors Well

Well