

SOUTHEASTERN DISTRICT HEALTH DEPARTMENT
INDIVIDUAL SEWAGE DISPOSAL INSTALLATION PERMIT

Permit No. _____ Date 10-2-72
Installation for JACK Slayden at T6S R34E Sec. 5
(Name) (Legal description of property)

Address of Installation W. Chubbuck - (Anderson) Sub

No. Living Units 1 Bedrooms 2 People Served _____ Water Supply—Private Public _____ Applicant is: Owner Contractor _____ Other _____

FHA _____ FARM HOME VA _____ CONV. _____ EXISTING _____ NO. _____

Septic Tank 1000 gal. Perc. Rate _____ Min./in. Min. Depth to Ground Water _____ ft.
Effluent Disposal: Effective Area Required 3000 sq. ft. Soil System: Soil Profile clay overlay - sand & gravel
Field Drain _____ Absorption Bed _____ Standard Modified _____ Seepage Pit Dimensions 10x10

Distance from Disposal Area to:
Property Lines: Front 710 ft. Back 710 ft. Side 710 ft. Dwelling Foundation 20 ft. Well 100 ft.
Surface Water _____ ft. Nearest Neighbor's Well 100 ft. Plot Plan Submitted and Approved Septic Tank 10 ft.

Remarks: 1 acre
Applicant Jack S. Slayden Paid _____ Bill _____ No Fee
Address 1011 Rock #12 Permit Issued by Jaren Salzman

INSPECTION: Septic Tank Size 1000 Standpipe 110 Depth to Manhole 2'

Distance from Septic Tank to: Dwelling Foundation 20 ft. Well 70 ft. Nearest Neighbor's Well 90 ft.


Effluent Disposal: Effective Area _____ sq. ft.
Field Drain _____ Absorption Bed _____ Standard Modified _____ Seepage Pit Dimensions 11x(14x15)
Pipe Size 4" cast No. of Lines _____ Length _____ Depth _____

Distance from Disposal Area to:
Property Lines: Front 100 ft. Back 250 ft. Side 220 ft. Dwelling Foundation 70 ft. Well 100 ft.
Surface Water _____ ft. Water Service Piping 90 ft. Depth to Gravel 6 ft. Nearest Neighbor's Well 120 ft.

Approved Not Approved _____ Inspected 3/27/73 by Jaren Salzman Installed by Kogen
(Date)

Remarks _____

Applicant's sketch of house, proposed sewage layout and all adjacent wells (dimension between all components) --

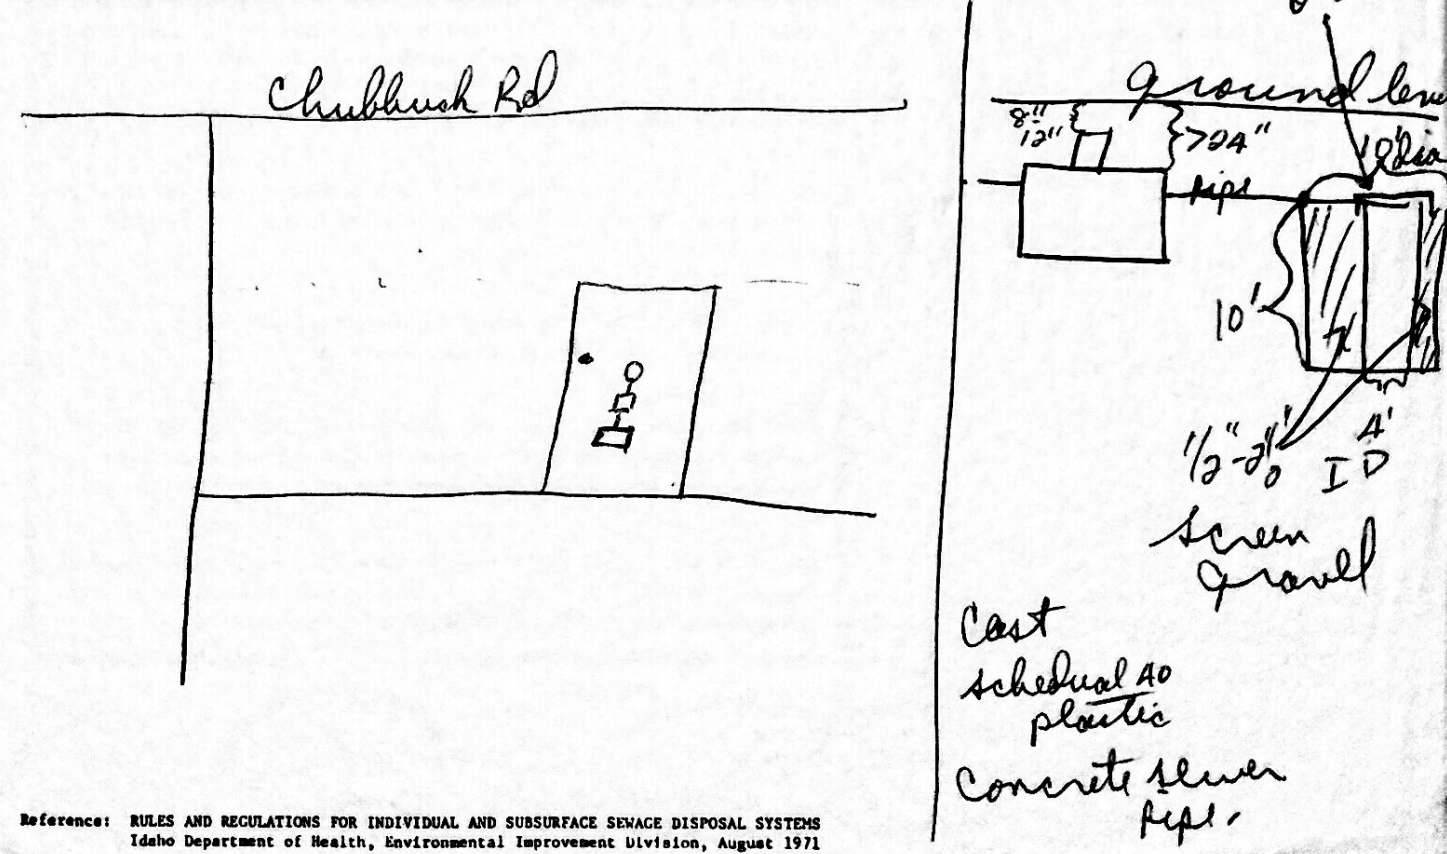

Reference: RULES AND REGULATIONS FOR INDIVIDUAL AND SUBSURFACE SEWAGE DISPOSAL SYSTEMS
Idaho Department of Health, Environmental Improvement Division, August 1971