

SOUTHEASTERN DISTRICT HEALTH DEPARTMENT
INDIVIDUAL SEWAGE DISPOSAL INSTALLATION PERMIT

T6S, R34E, Sec 5

Permit No. _____ Date 26 July 1972
 Installation for John E. Roeder at West Chubbuck Road
(Name) (Legal description of property)
 Address of Installation between pulkin and Rio Vista - 600 feet back
 No. Living Units 1 Bedrooms 3 People Served _____ Water Supply—Private & shared Owner _____
Public _____ Applicant is: Contractor _____
 Other _____
 FHA _____ FARM HOME _____ VA _____ CONV. other EXISTING _____ NO. _____
 Septic Tank 900 gal. minimum Perc. Rate _____ Min./in. Min. Depth to Ground Water _____ ft.
 Effluent Disposal: Effective Area Required 500 sq. ft. Soil System: _____
 Soil Profile gravel - 1 ft top soil.
 Field Drain _____ Absorption Bed _____ Standard _____ Modified _____ Seepage Pit _____ Dimensions _____

Distance from Disposal Area to:
 Property Lines: Front 10 ft. Back 10 ft. Side 10 ft. Dwelling Foundation _____ ft. Well _____ ft.
 Surface Water _____ ft. Nearest Neighbor's Well 100 ft. Plot Plan Submitted and Approved X Septic Tank _____ ft.


Remarks: _____
 Applicant John E. Roeder Paid _____ Bill _____ No Fee X
 Address _____ Permit Issued by Harry Ferguson, Jr.

INSPECTION: Septic Tank Size 1000 Standpipe no Depth to Manhole 5'
 Distance from Septic Tank to: Dwelling Foundation 50 ft. Well 50 ft. Nearest Neighbor's Well 50 ft.
 Effluent Disposal: Effective Area 350 sq. ft.
 Field Drain _____ Absorption Bed _____ Standard ✓ Modified _____ Seepage Pit _____ Dimensions d 14 depth 10x10
 Pipe Size 4" No. of Lines _____ Length _____ Depth _____
 Distance from Disposal Area to:
 Property Lines: Front 100 ft. Back 100 ft. Side 750 ft. Dwelling Foundation 100 ft. Well 120 ft.
 Surface Water _____ ft. Water Service Piping _____ ft. Depth to Gravel 6 ft. Nearest Neighbor's Well 120 ft.

Approved ✓ Not Approved _____ Inspected 2/20/73 by Jane Palmer Installed by Jorden Stuart
(Date)
 Remarks with basement. on one acre.

Applicant's sketch of house, proposed sewage layout and all adjacent wells (dimension between all components) --

8-9-72
 approved
 change to
 350 sq ft
 lat

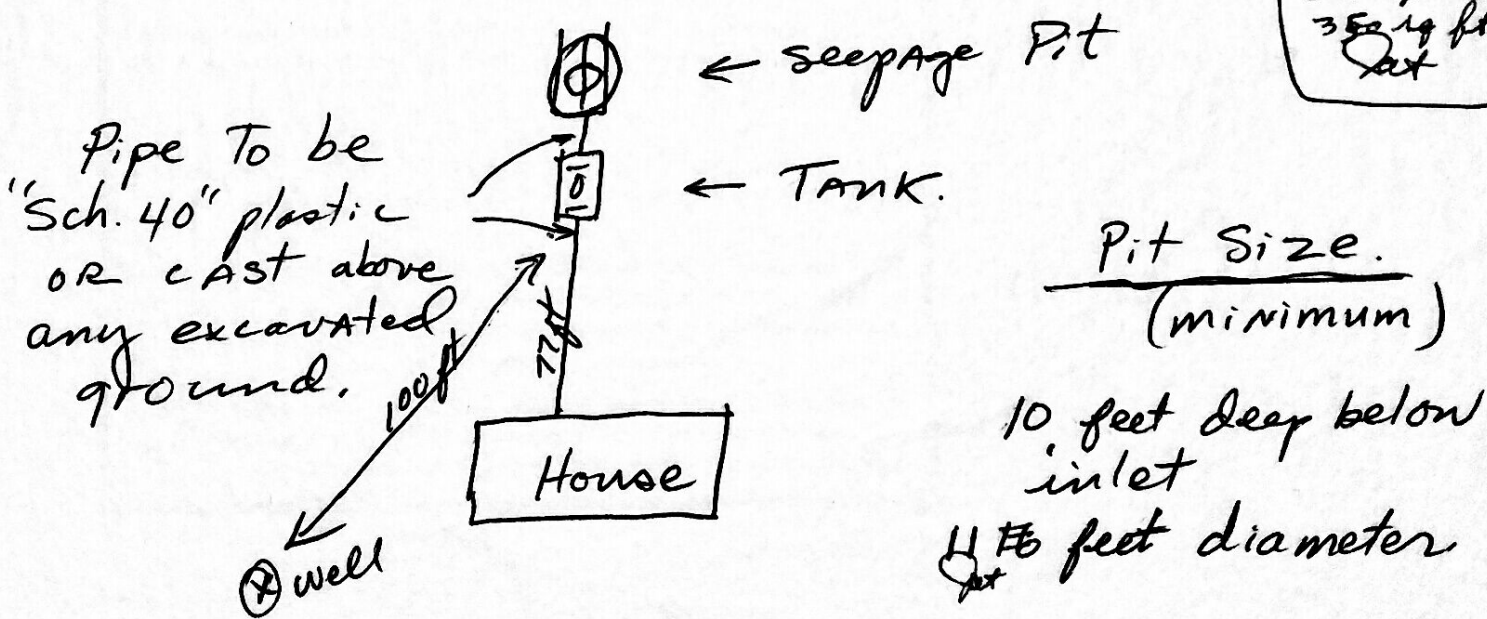

To be built according to Bulletin #6.
 State Health Dept.