

SOUTHEASTERN DISTRICT HEALTH DEPARTMENT
INDIVIDUAL SEWAGE DISPOSAL INSTALLATION PERMIT

Permit No. T9673B Date July 18, 1973
 Installation for Joyce Banks at Tr 533 T65 R 34 B M
 (Name) (Legal description of property)
 Address of Installation Hawthorn Rd
 No. Living Units 1 Bedrooms 3 People Served _____ Water Supply--Private _____ Public X Applicant is: Owner _____ Contractor _____ Other _____
 FHA _____ FARM HOME _____ VA _____ CONV. X EXISTING _____ NO. _____

Septic Tank 1000 gal. basement Perc. Rate _____ Min./in. Min. Depth to Ground Water _____ ft.
 Effluent Disposal: Effective Area Required 300 sq. ft. Soil System: Soil Profile gravel
 Field Drain _____ Absorption Bed _____ Standard X Modified _____ Seepage Pit X Dimensions 10x10


Distance from Disposal Area to: 1 Ave
 Property Lines: Front 710 ft. Back 710 ft. Side 710 ft. Dwelling Foundation 20 ft. Well 7100 ft.
 Surface Water _____ ft. Nearest Neighbor's Well 7100 ft. Plot Plan Submitted and Approved OK Septic Tank 10 ft.

Remarks: Keep 100 feet from drainage ditch area.
 Applicant X Susan Banks Paid _____ Bill _____ No Fee X
 Address _____ Permit Issued by Jaren Tolman

INSPECTION: Septic Tank Size 1000 Standpipe _____ Depth to Manhole _____
 Distance from Septic Tank to: Dwelling Foundation 10 ft. Well _____ ft. Nearest Neighbor's Well _____ ft.
 Effluent Disposal: Effective Area 300 sq. ft.
 Field Drain _____ Absorption Bed _____ Standard _____ Modified X Seepage Pit X Dimensions 10x10
 Pipe Size _____ No. of Lines _____ Length _____ Depth _____

Distance from Disposal Area to:
 Property Lines: Front 710 ft. Back 710 ft. Side 710 ft. Dwelling Foundation 710 ft. Well ~300 ft.
 Surface Water _____ ft. Water Service Piping 710 ft. Depth to Gravel 4' ft. Nearest Neighbor's Well 7100 ft.
 Approved X Not Approved _____ Inspected 8-29-73 by Jaren Tolman Installed by Imperial
 (Date)
 Remarks well will be shared w/ Dennis Oye

Applicant's sketch of house, proposed sewage layout and all adjacent wells (dimension between all components) --

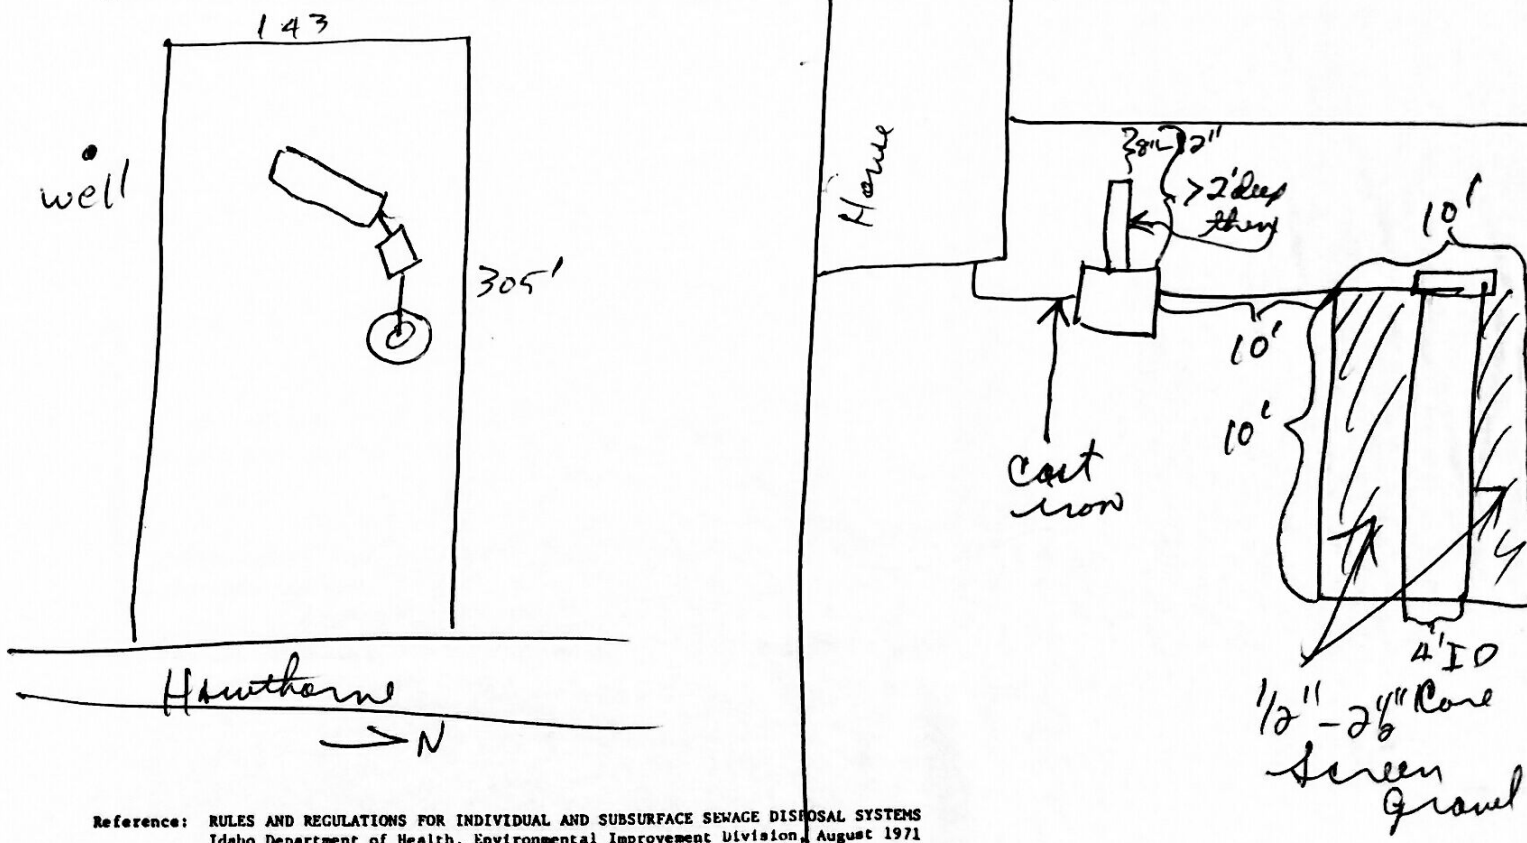

Reference: RULES AND REGULATIONS FOR INDIVIDUAL AND SUBSURFACE SEWAGE DISPOSAL SYSTEMS
 Idaho Department of Health, Environmental Improvement Division, August 1971