

T65 R 34E Sec 32

SOUTHEASTERN DISTRICT HEALTH DEPARTMENT  
INDIVIDUAL SEWAGE DISPOSAL INSTALLATION PERMIT

Permit No. \_\_\_\_\_ Date 26 March 1973  
Installation for MR. + MRS. Dennis Shappart Philbin Rd. near  
(Name) (Legal description of property)

Address of Installation (South) of Siphon  
No. Living Units 1 Bedrooms 3 People Served 2 Water Supply--Private  Public \_\_\_\_\_ Applicant is: Owner  Contractor \_\_\_\_\_ Other \_\_\_\_\_  
FHA \_\_\_\_\_ FARM HOME \_\_\_\_\_ VA \_\_\_\_\_ CONV. \_\_\_\_\_ EXISTING \_\_\_\_\_ NO. \_\_\_\_\_

Septic Tank 900 gal. minimum (Fowler) Perc. Rate \_\_\_\_\_ Min./in. Min. Depth to Ground Water \_\_\_\_\_ ft.  
Effluent Disposal: Effective Area Required 300 sq. ft. Soil System: Soil Profile gravel below topsoil  
Field Drain \_\_\_\_\_ Absorption Bed \_\_\_\_\_ Standard \_\_\_\_\_ Modified \_\_\_\_\_ Seepage Pit  Dimensions \_\_\_\_\_


Distance from Disposal Area to:  
Property Lines: Front 10 ft. Back 10 ft. Side 10 ft. Dwelling Foundation 20 ft. Well 100 ft.  
Surface Water \_\_\_\_\_ ft. Nearest Neighbor's Well 100 ft. Plot Plan Submitted and Approved  Septic Tank \_\_\_\_\_ ft.

Remarks: \_\_\_\_\_  
Applicant  Dennis Shappart Paid \_\_\_\_\_ Bill \_\_\_\_\_ No Fee   
Address Philbin Rd. Box 122 Permit Issued by Harry Ferguson / Tolman

INSPECTION: Septic Tank Size 1000 Standpipe yes Depth to Manhole 24"  
Distance from Septic Tank to: Dwelling Foundation 20 ft. Well 90 ft. Nearest Neighbor's Well 200 ft.  
Effluent Disposal: Effective Area 300 sq. ft.  
Field Drain \_\_\_\_\_ Absorption Bed \_\_\_\_\_ Standard  Modified \_\_\_\_\_ Seepage Pit  Dimensions 10x10  
Pipe Size 4" No. of Lines \_\_\_\_\_ Length \_\_\_\_\_ Depth \_\_\_\_\_

Distance from Disposal Area to:  
Property Lines: Front 10 ft. Back >100 ft. Side 10 ft. Dwelling Foundation 30 ft. Well 100 ft.  
Surface Water \_\_\_\_\_ ft. Water Service Piping \_\_\_\_\_ ft. Depth to Gravel 3 ft. Nearest Neighbor's Well >200 ft.  
Approved  Not Approved \_\_\_\_\_ Inspected 9-15-73 by Jaren Tolman Installed by Marion Christensen  
(Date)

Remarks House with basement (Trailer Temporary) on more than 1 acre (5 acres).  
Applicant's sketch of house, proposed sewage layout and all adjacent wells (dimension between all components) \_\_\_\_\_

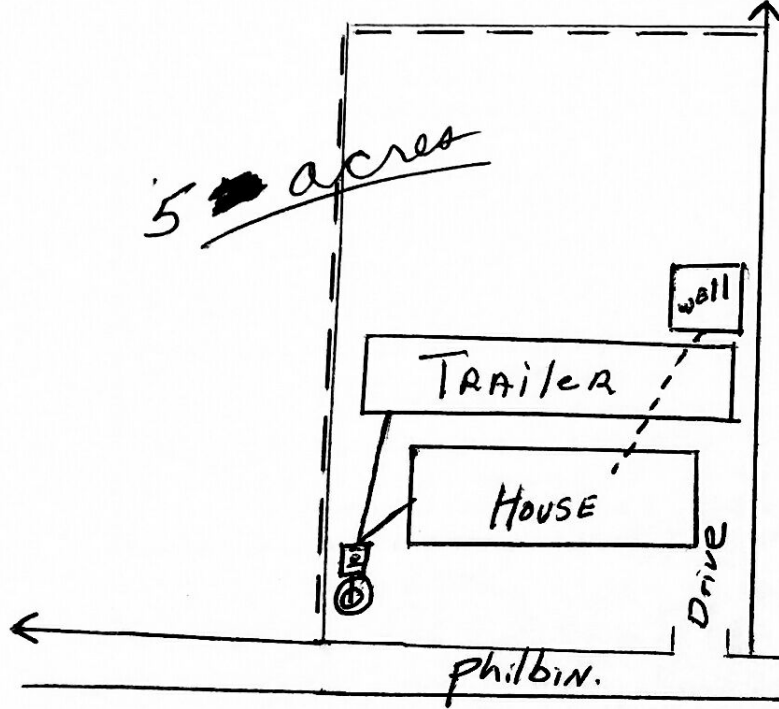

Seepage Pit size:  
10 ft. deep below inlet  
10 ft. diameter.

OR  
Alternatives

To be installed according to: