

replace permit of 1-5-73 & voids that permit

SOUTHEASTERN DISTRICT HEALTH DEPARTMENT
INDIVIDUAL SEWAGE DISPOSAL INSTALLATION PERMIT

Permit No. T10873 Date 22 JAN 73
Installation for Dennis Leslie at T65 R34 S5
(Name) (Legal description of property)

Address of Installation Syphon Road #2

No. Living Units 1 Bedrooms 3 People Served _____ Water Supply--Private Public _____ Applicant is: Owner Contractor Other _____

FHA _____ FARM HOME _____ VA _____ CONV. _____ EXISTING _____ NO. _____


Septic Tank 1000 gal. Perc. Rate _____ Min./in. Min. Depth to Ground Water _____ ft.
Effluent Disposal: Effective Area Required 300 sq. ft. Soil System: Soil Profile gravel
Field Drain _____ Absorption Bed _____ Standard Modified _____ Seepage Pit _____ Dimensions 10x10

Distance from Disposal Area to:
Property Lines: Front 710 ft. Back 710 ft. Side 710 ft. Dwelling Foundation 20 ft. Well 100 ft.
Surface Water 300 ft. Nearest Neighbor's Well 100 ft. Plot Plan Submitted and Approved OK Septic Tank 10 ft.

Remarks: Will share well with adjoining property south (plot #1)
Applicant Dennis Leslie Paid _____ Bill _____ No Fee
Address 742 Victor Roc Permit Issued by Jaren Solman

INSPECTION: Septic Tank Size 1000 Standpipe no Depth to Manhole 1'
Distance from Septic Tank to: Dwelling Foundation 10 ft. Well 750 ft. Nearest Neighbor's Well 200 ft.
Effluent Disposal: Effective Area 300 sq. ft.
Field Drain _____ Absorption Bed _____ Standard Modified _____ Seepage Pit 2 Dimensions 10x10
Pipe Size 4" No. of Lines sch 40 Length _____ Depth 10

Distance from Disposal Area to:
Property Lines: Front 750 ft. Back 750 ft. Side 710 ft. Dwelling Foundation 20 ft. Well 2000 ft.
Surface Water _____ ft. Water Service Piping _____ ft. Depth to Gravel 4 ft. Nearest Neighbor's Well 2000 ft.
Approved Not Approved _____ Inspected 5-2-73 by Jaren Solman Installed by Porter const
(Date)
Remarks contains 1 acre

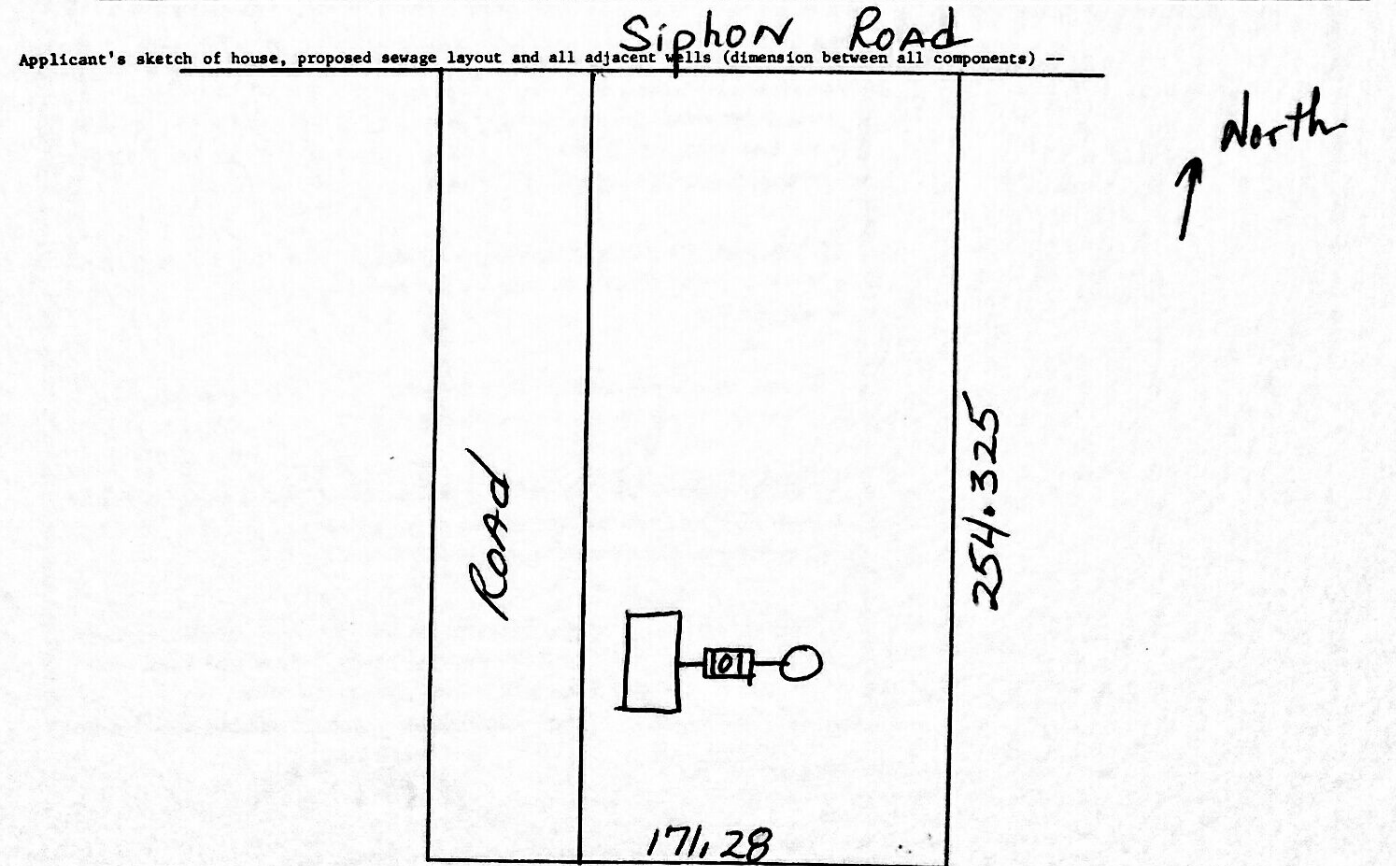

Reference: RULES AND REGULATIONS FOR INDIVIDUAL AND SUBSURFACE SEWAGE DISPOSAL SYSTEMS
Idaho Department of Health, Environmental Improvement Division, August 1971

Contains 1 acre