

SOUTHEASTERN DISTRICT HEALTH DEPARTMENT
INDIVIDUAL SEWAGE DISPOSAL INSTALLATION PERMIT

Permit No. _____ Date 3-27-73
Installation for Matkins John R at 172 A. NE 47th St. Sec. 38, T6S, R34E, B3m
(Name) (Legal description of property)

Address of Installation Trail Creek
No. Living Units 1 Bedrooms 3 People Served 2 Water Supply--Private X Public _____ Applicant is: Owner _____ Contractor X Other _____
FHA _____ FARM HOME _____ VA _____ CONV. _____ EXISTING _____ NO. none

Septic Tank 1000 gal. Perc. Rate _____ Min./in. Min. Depth to Ground Water none ft.
Effluent Disposal: Effective Area Required 4.50 min. sq. ft. Soil System: 3 Soil Profile loose silt & gravel
Field Drain X Absorption Bed _____ Standard _____ Modified _____ Seepage Pit X Dimensions _____

Distance from Disposal Area to:
Property Lines: Front 250 ft. Back 60 ft. Side 50 ft. Dwelling Foundation _____ ft. Well 130 ft.
Surface Water _____ ft. Nearest Neighbor's Well 500 ft. Plot Plan Submitted and Approved _____ Septic Tank _____ ft.

Remarks: absorption area to be computed after perc test is made.
Applicant John R Matkins Paid _____ Bill _____ No Fee X
Address 58 Maurice Dr. Permit Issued by Paul Cleaves


INSPECTION: Septic Tank Size 1000 Standpipe 1/2 Depth to Manhole 2
Distance from Septic Tank to: Dwelling Foundation 10 ft. Well 250 ft. Nearest Neighbor's Well 100 ft.

Effluent Disposal: Effective Area 4.50 sq. ft.
Field Drain _____ Absorption Bed _____ Standard X Modified _____ Seepage Pit X Dimensions 10' x 15'
Pipe Size 4" No. of Lines _____ Length _____ Depth _____

Distance from Disposal Area to:
Property Lines: Front 210 ft. Back 210 ft. Side 210 ft. Dwelling Foundation 70 ft. Well 2100 ft.
Surface Water 150 ft. Water Service Piping _____ ft. Depth to Gravel none ft. Nearest Neighbor's Well 2100 ft.

Approved X Not Approved _____ Inspected 4/29/73 by Jaren Tolman Installed by Jess Coffin
Remarks Construct bulletin #6 status code - A-100

Applicant's sketch of house, proposed sewage layout and all adjacent wells (dimension between all components) --

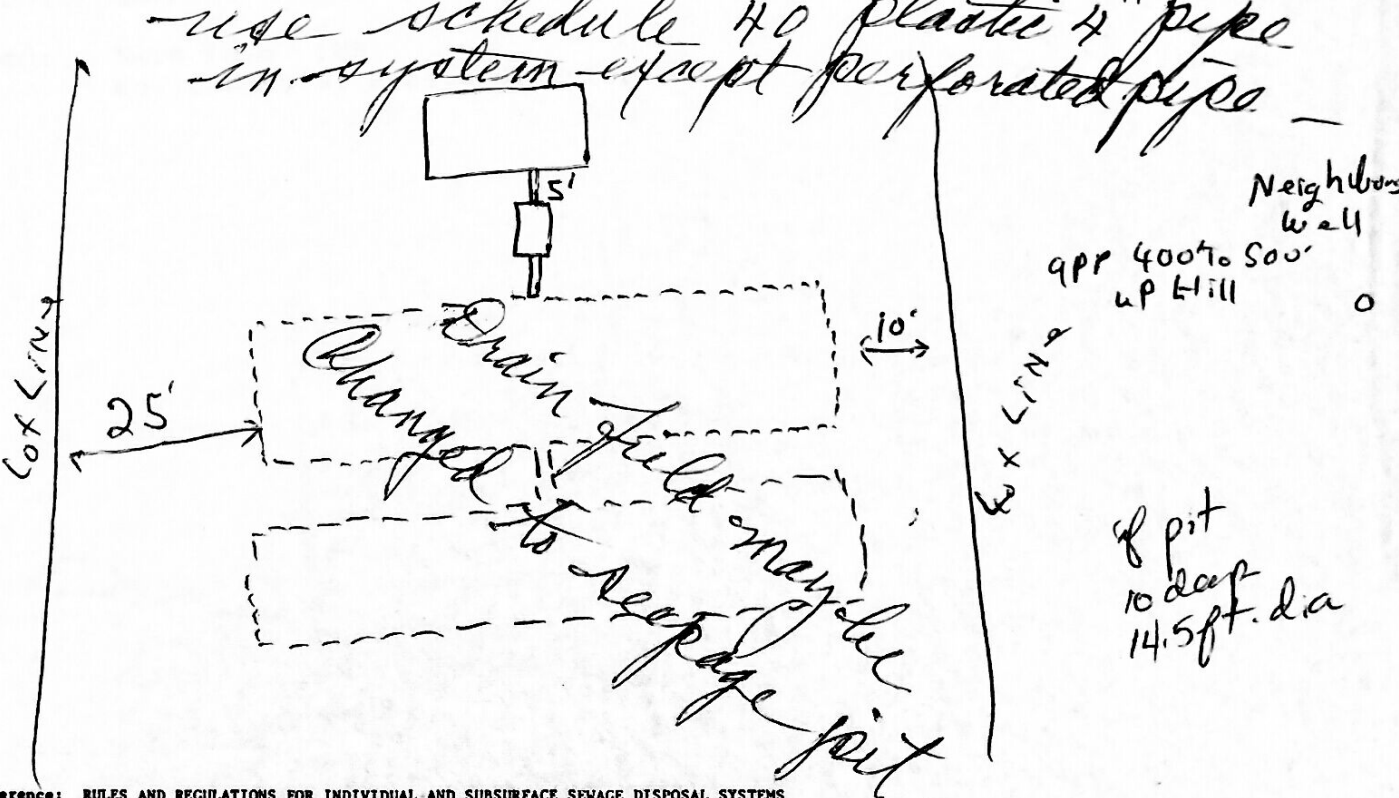

Reference: RULES AND REGULATIONS FOR INDIVIDUAL AND SUBSURFACE SEWAGE DISPOSAL SYSTEMS
Idaho Department of Health, Environmental Improvement Division, August 1971