

SOUTHEASTERN DISTRICT HEALTH DEPARTMENT
INDIVIDUAL SEWAGE DISPOSAL INSTALLATION PERMIT

Permit No. _____ Date 25 March 75
 Installation for Kenneth Lyon at NE 1/4 NW 1/4 and the NW 1/4 NE 1/4 Sec 33
 (Name) (Legal description of property) T65 R34E

Address of Installation _____
 No. Living Units 1 Bedrooms 4 People Served 5 Water Supply--Private Public _____
 Applicant is: Owner Contractor _____ Other _____
 FHA _____ FARM HOME _____ VA _____ CONV. _____ EXISTING _____ NO. _____

Septic Tank 1000 gal. may be 1000 gal
 Effluent Disposal: Effective Area Required 1000 sq. ft. Soil System: Perc. Rate 36 Min./in. Min. Depth to Ground Water _____ ft.
 Field Drain Absorption Bed _____ Standard _____ Modified _____ Seepage Pit _____ Dimensions _____


Distance from Disposal Area to:
 Property Lines: Front 10 ft. Back 10 ft. Side 10 ft. Dwelling Foundation 20 ft. Well 100 ft.
 Surface Water _____ ft. Nearest Neighbor's Well _____ ft. Plot Plan Submitted and Approved _____ Septic Tank 5 ft.

Remarks: call before backfilling
 Applicant Kenneth Lyon Paid _____ Bill _____ No Fee
 Address Box 4392 Pocatello Permit Issued by William H. Maitland

INSPECTION: Septic Tank Size 1000 Standpipe _____ Depth to Manhole _____
 Distance from Septic Tank to: Dwelling Foundation _____ ft. Well _____ ft. Nearest Neighbor's Well _____ ft.
 Effluent Disposal: Effective Area 1000 sq. ft.
 Field Drain _____ Absorption Bed Standard Modified _____ Seepage Pit _____ Dimensions _____
 Pipe Size _____ No. of Lines _____ Length _____ Depth _____

Distance from Disposal Area to:
 Property Lines: Front _____ ft. Back _____ ft. Side _____ ft. Dwelling Foundation _____ ft. Well _____ ft.
 Surface Water _____ ft. Water Service Piping _____ ft. Depth to Gravel _____ ft. Nearest Neighbor's Well _____ ft.
 Approved Not Approved _____ Inspected By Phone 12 May 75 by W.H. Maitland Installed by Richard Brauning
 (Date)

Applicant's sketch of house, proposed sewage layout and all adjacent wells (dimension between all components) --

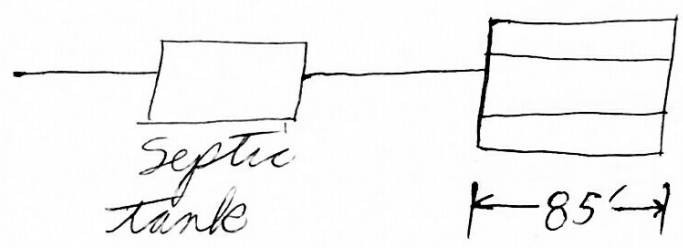

4 drain lines 85' long
changed to a
absorption bed
of 20' by 50' - 2 May 1975

Install according to

Reference: RULES AND REGULATIONS FOR INDIVIDUAL AND SUBSURFACE SEWAGE DISPOSAL SYSTEMS
 Idaho Department of Health, Environmental Improvement Division, August 1971