

SOUTHEASTERN DISTRICT HEALTH DEPARTMENT
INDIVIDUAL SEWAGE DISPOSAL INSTALLATION PERMIT

Permit No. 2125 for Philip Holsted Date 22 March 1976
Installation for Keith B. McCordell at N 1/2 NW 1/4 Sec 21 T 6 S R 34 E
(Name) (Legal description of property)

Address of Installation Kraft Rd
No. Living Units 1 Bedrooms 2 People Served 5 Water Supply—Private Public
Applicant is: Owner Contractor Other
FHA FARM HOME VA CONV. EXISTING NO:

Septic Tank 1000 gal.
Effluent Disposal: Effective Area Required 250 ~~500~~ sq. ft. Soil System: Perc. Rate 5 Min./in. Min. Depth to Ground Water ft.
Soil Profile
Field Drain Absorption Bed Standard Modified Seepage Pit Dimensions


Distance from Disposal Area to:
Property Lines: Front 10 ft. Back 10 ft. Side 10 ft. Dwelling Foundation 20 ft. Well 100 ft.
Surface Water ft. Nearest Neighbor's Well ft. Plot Plan Submitted and Approved Septic Tank 5 ft.

Remarks: Have sewer system inspected and approved before backfilling
Applicant X Mrs Keith B. McCordell Paid Bill No Fee
Address Rt 1 No Box 136, Poc. Ida Permit Issued by William H. Nailor

INSPECTION: Septic Tank Size 1000 Standpipe Depth to Manhole 18"
Distance from Septic Tank to: Dwelling Foundation 5 ft. Well ft. Nearest Neighbor's Well ft.
Effluent Disposal: Effective Area 448 sq. ft.
Field Drain Absorption Bed Standard Modified Seepage Pit Dimensions 8' x 15' wide
Pipe Size No. of Lines Length Depth

Distance from Disposal Area to:
Property Lines: Front 70 ft. Back 70 ft. Side 70 ft. Dwelling Foundation 40 ft. Well 100 ft.
Surface Water ft. Water Service Piping 80 ft. Depth to Gravel 4 ft. Nearest Neighbor's Well 1000 ft.
Approved Not Approved Inspected Aug 13 76 by Loed Huffman Installed by Stanger
Remarks Pipe must be finished before backfilling

Applicant's sketch of house, proposed sewage layout and all adjacent wells (dimension between all components) --

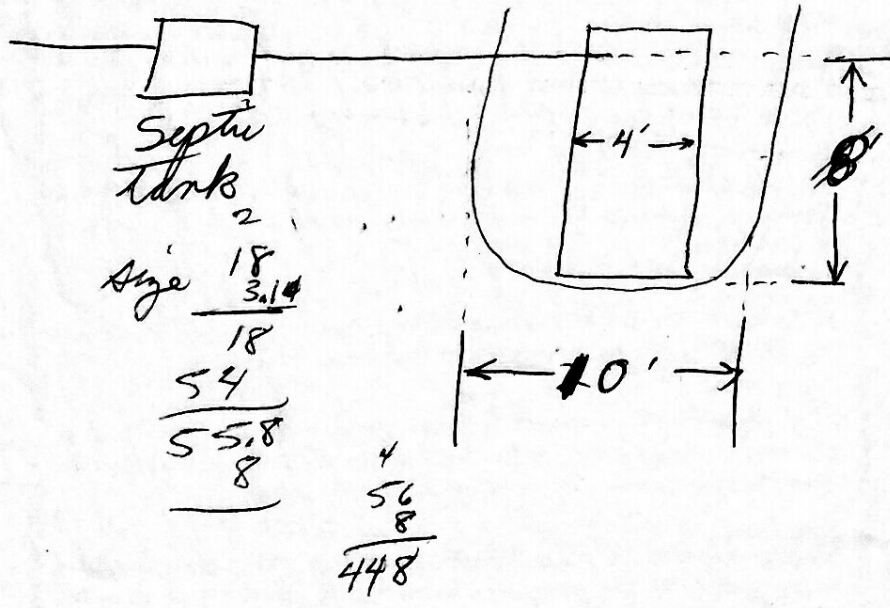

14 June 1976
change size
of pit To 6' deep
and 13 ft diameter

otherwise install as per