1:30 -SOUTHEASTERN DISTRICT HEALTH DEPARTMENT INDIVIDUAL SEVAGE DISPOSAL INSTALLATION PERMIT Installation for Mike Scarding \_ at for 3 Address of Installation Buffalo Road 1 mile north of E. Chubbuck Ro Water Supply--Private \_\_\_\_\_\_Public People Served FHA \_\_\_\_\_ FARM HOME \_ CONV. EXISTING \_ Septic Tank 1000 gal. Septic Tank 1000 gal.

Effluent Disposal: Effective Area Required 600 sq. ft. Soil System:


Soil Profile Field Drain \_\_\_\_\_ Absorption Bed \_\_\_ Standard \_\_\_\_\_ Modified \_\_\_\_\_ Seepage Pit \_\_\_\_ Dimensions Distance from Disposal Area to: Property Lines: Front 10 ft. Back 10 ft. Side 10 ft. Dwelling Foundation 20 ft. Well 100 ft. Surface Water \_\_\_\_\_ft. Nearcst Neighbor's Well \_\_\_\_\_ft. Plot Plan Submitted and Approved Remarks: Have server system inspected + approved INSPECTION: Septic Tank Size Standpipe Distance from Septic Tank to: Dwelling Foundation \_\_\_\_\_ ft. Well \_\_\_\_ ft. Nearest Neighbor's Well \_\_\_\_ Effluent Disposal: Effective Area \_\_\_\_\_\_ sq. ft. Field Drain \_\_\_\_\_ Absorption Bed \_\_\_\_ Standard \_\_\_\_ Modified \_\_\_ Seepage Pit \_\_\_\_ Dimensions \_

Property Lines: Front \_\_\_\_\_ft. Back \_\_\_\_ft. Side \_\_\_\_ft. Dwelling Foundation \_\_\_\_\_ft. Well \_\_\_\_\_ft.

Approved \_\_\_\_ Not Approved \_\_\_ Inspected 30 May 184 WIH Markan Winstalled by John Lung

ft. Nearest Neighbor's Well

Applicant's sketch of house, proposed sewage layout and all adjacent wells (dimension between all components) --

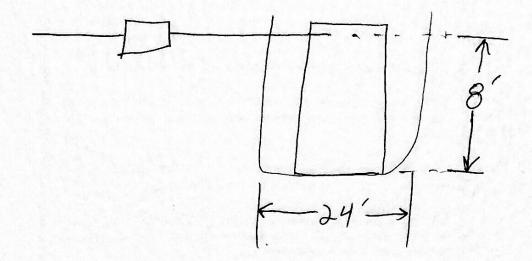

Pipe Size \_\_\_\_\_ No. of Lines \_\_\_\_ Length \_\_\_\_ Depth \_\_\_

Surface Water \_\_\_\_\_ ft. Water Service Piping \_\_\_\_\_ ft. Depth to Gravel \_\_\_\_

Distance from Disposal Area to: