69 04/04/97 GW

JURISDICTION 300 | 65 4-2-97

SOUTHEASTERN DISTRICT HEALTH DEPARTMENT
465 MEMORIAL DRIVE POCATELLO, ID

FEE PD X Y ___ N
PERMIT # 118352

TRAVEL TIME: ___ - 30 / ___
INSPECTION TIME: 30 130 / ___

Code G

**APPLICATION AND PERMIT VALID FOR ONE YEAR FROM DATE OF ISSUANCE

NAME	PHONE	PROPERTY ADDRESS
Dale Jones	238 0461	Facer Mountain Rd

MAILING ADDRESS: 1265 Cottage
STREET/P.O. BOX
CITY Pocatello
STATE Idaho ZIP 83201

LEGAL DESCRIPTION: LOT SIZE (ACRES) 5.0
¼ SECTION SE SECTION 21 TOWNSHIP 6 RANGE 34
LOT # ___ BLOCK # ___ SUBDIVISION ___
PARCEL # 12385302302 FROM TAX ASSESSOR'S OFFICE

SEPTIC TANK SIZE	EST TYPE	EFFECTIVE DISPOSAL AREA	SOIL TYPE	MAXIMUM DEPTH BELOW GROUND SURFACE	# BEDROOMS
1750 gal.	232	1101 SQ.FT.	B2	2 ft	7

INSTALLATION MUST BE BY LICENSED SEWER INSTALLER OR HOME/LANDOWNER

EHS SIGNATURE	EHS #	APPLICANT SIGNATURE	DATE
[signature]	69	Dale Jones	3-11-97

REMARKS Do not approve until Kenny Campbell gets licensed. He dug Trenches.

INSPECTION

THE DISTRICT HEALTH DEPARTMENT SHALL BE NOTIFIED OF INSTALLATION 48 HOURS PRIOR TO INSTALLATION

SEPTIC TANK SIZE	STANDPIPE: ( ) YES (X) NO	MANHOLE DEPTH	DEPTH BELOW GROUND SURFACE	ROCK UNDER PIPE
2(1000) gal per cust's		at surface	2ft	Infi.

EFFECTIVE DISPOSAL AREA	INSTALLATION APPROVED ___ DISAPPROVED X	INSTALLER	INSTALLER #
1069 sq. ft.		Scott & Kenny Campbell	NA

EHS SIGNATURE	DATE	EHS #
[signature]	040997	69

REMARKS well was being installed at inspection time. As of 05/16/00 Kenny Campbell is not to be found. Though Mr Campbell never got licensed installation appears to be OK.

WATER SYSTEM

PLANS APPROVED	SAMPLE COLLECTED BY	DATE	STATE LAB INDICATES INTESTINAL BACTERIA
YES X NO ___			WERE ___ WERE NOT ___ FOUND

MIN. DISTANCES PER STANDARDS/REGS.	CHEMICAL PARAMETERS TESTED WITHIN LIMITS YES ___ NO ___	SYSTEM PUBLIC ___ PRIVATE X
YES X NO ___		

WELL (SPRING) APPEARS TO MEET CONSTRUCTION STANDARDS AT TIME OF INSPECTION ( ) YES ( ) NO	EHS SIGNATURE	EHS #

REMARKS

APPROVED PLANS

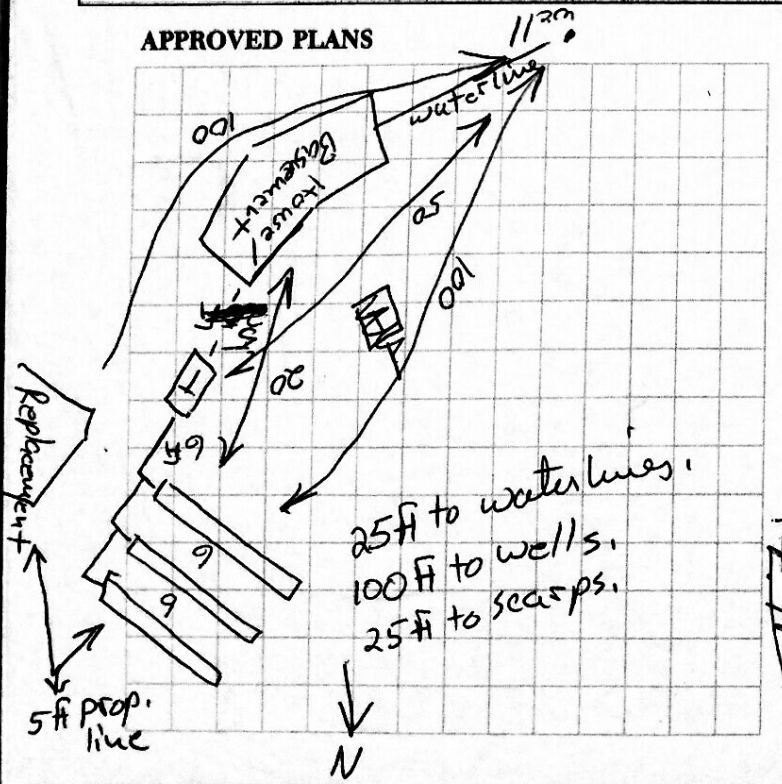
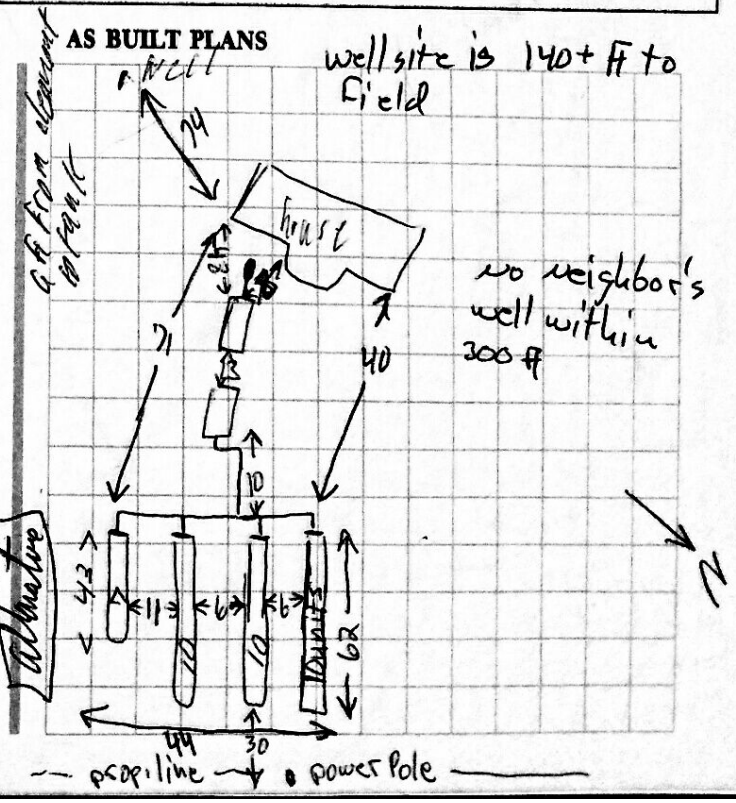
AS BUILT PLANS